




Rhif y Cais / Application Number : C17/0198/30/LL

Cynllun lleoliad ar gyfer adnabod y safle yn unig. Dim i raddfa.
Location Plan for identification purposes only. Not to scale.

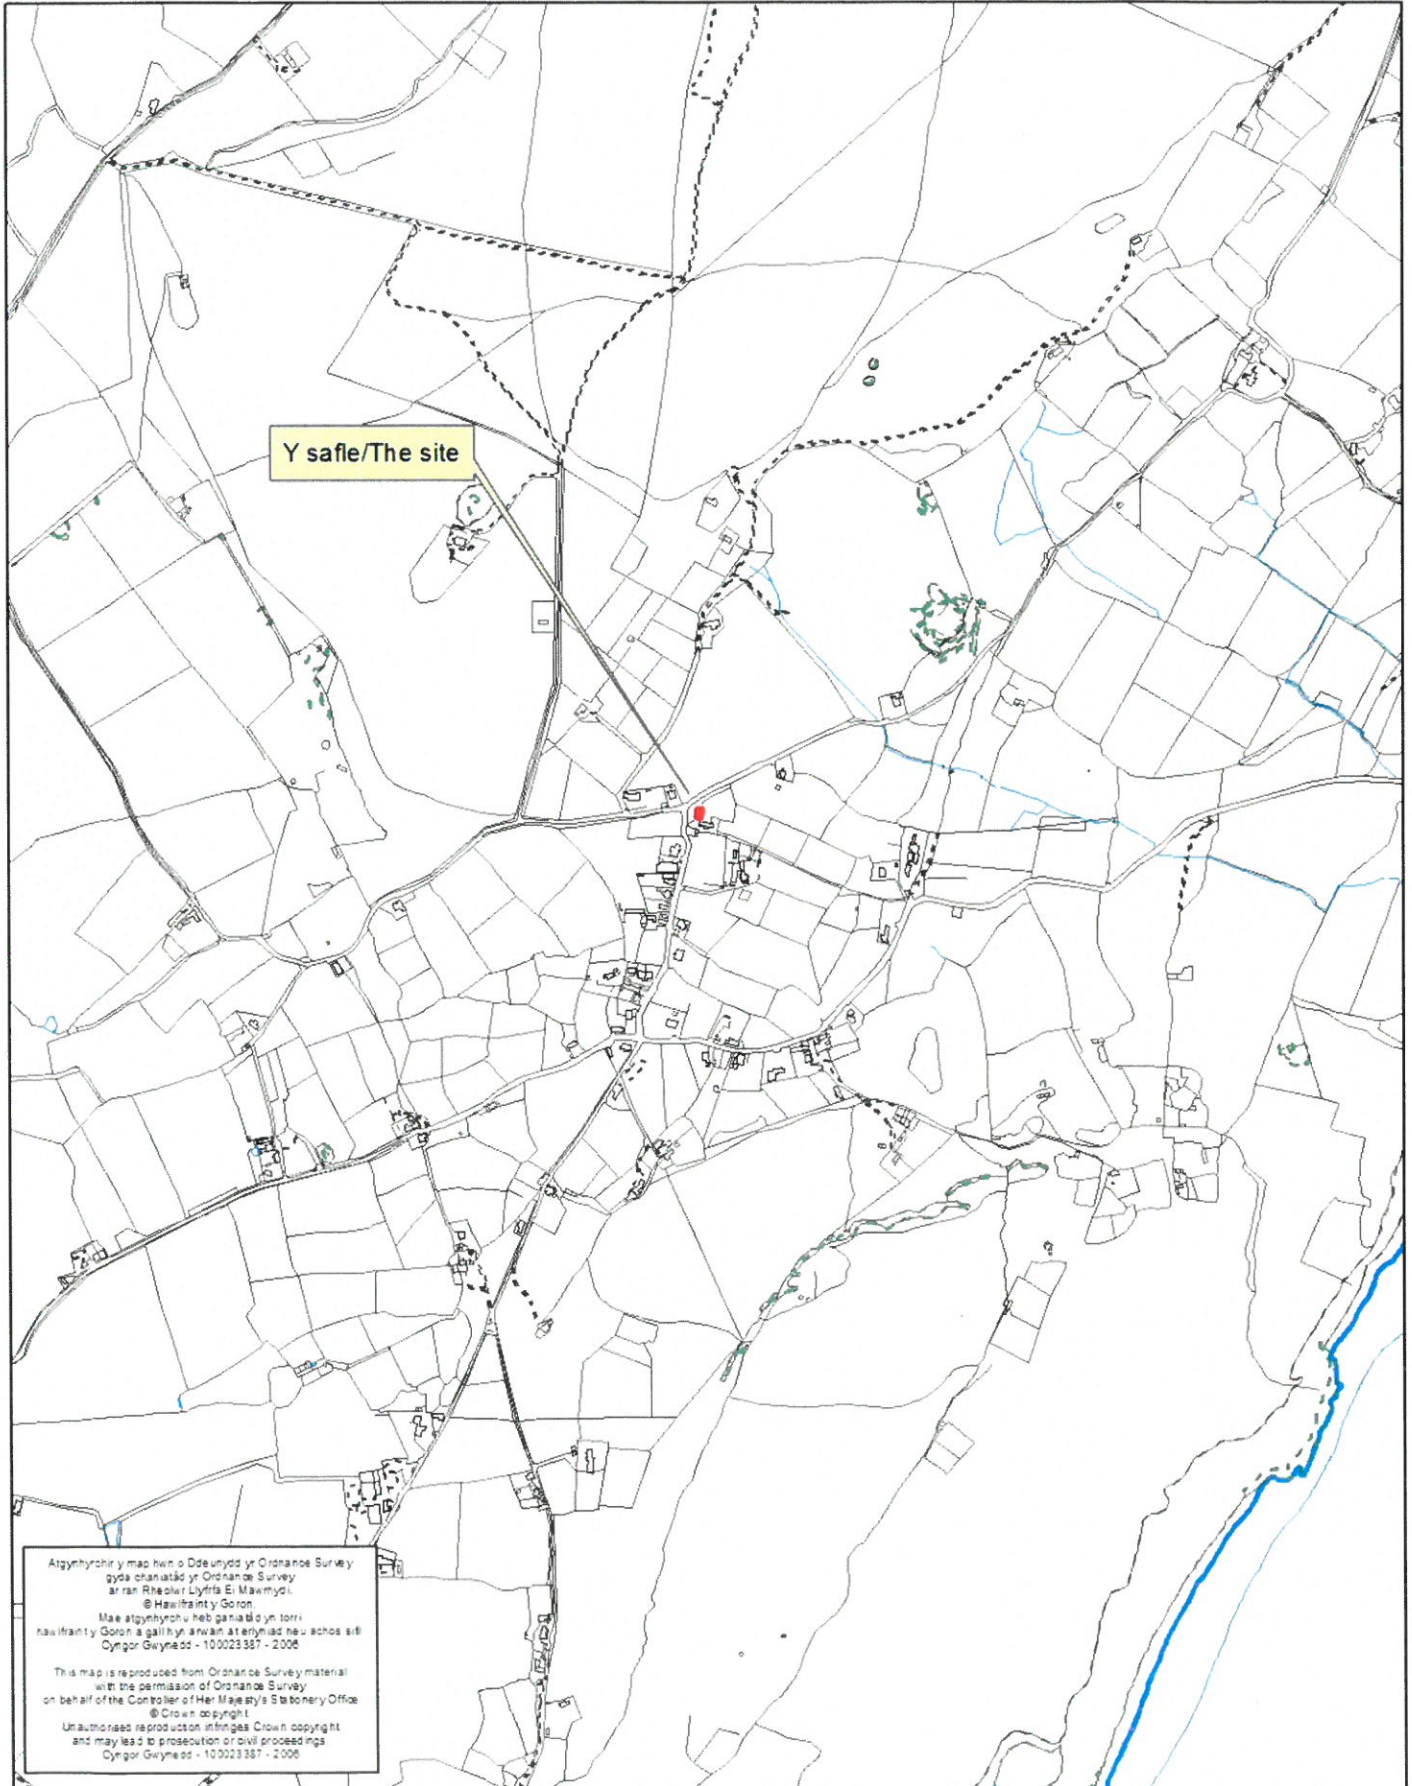


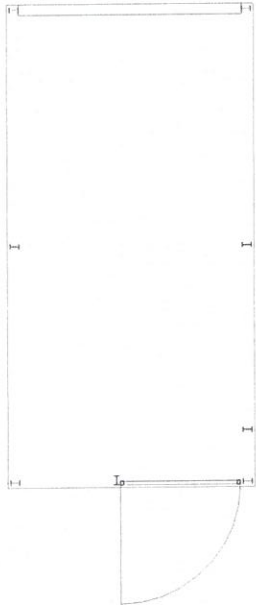


1 Level 0
1 : 100

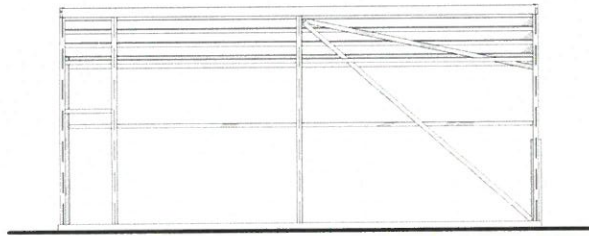


2 East
1 : 100

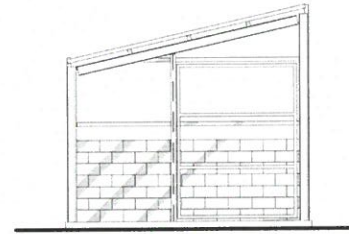


3 South
1 : 100

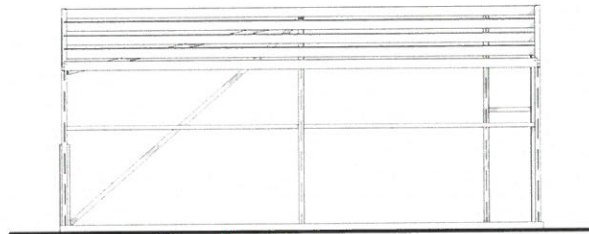

4 West
1 : 100

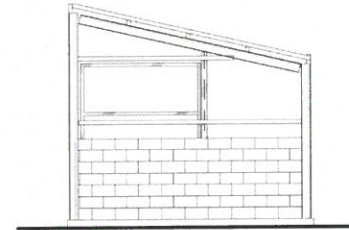

5 North
1 : 100

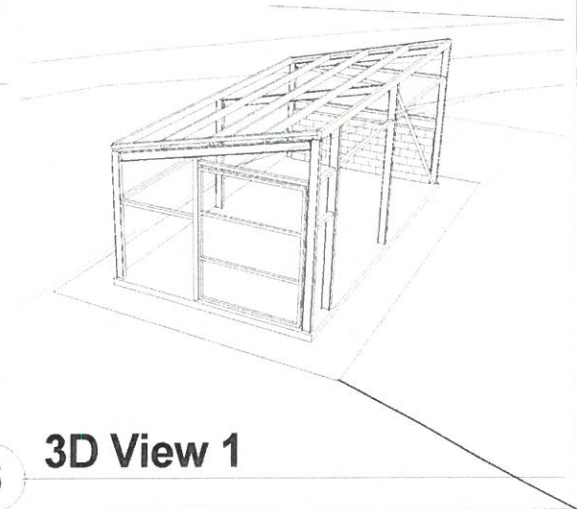

6 3D View 1

Do not scale this drawing. Contractors must check all dimensions from site. This drawing is copyright

No.	Description	Date



Haydn E. Williams Cyf.
 Syrfewyr Adeiladu Siartredig
 Chartered Building Surveyors

RICS
 Gellidara, Penrhos, Pwllheli, Gwynedd, LL53 7HF
 (01758) 614444
 info@haydnwilliams.com
 www.haydnwilliams.com

TEITL PROSIECT - PROJECT TITLE
Pwll Melyn, Rhiw
 TEITL - TITLE
As Existing

CLEIENT - CLIENT
Elizabeth Thornton


DYDDIAD - DATE 02/02/17	RHIF PROSIECT - PROJECT NUMBER (GRADDFA - SCALE (@ A3)) 0453 1 : 100
DARLYNWDYD GAN DRAWN BY HEW	RHIF CYNLLUN - DRAWING NUMBER 0453-A101
GWRWDYD GAN CHECKED BY GEW	REV

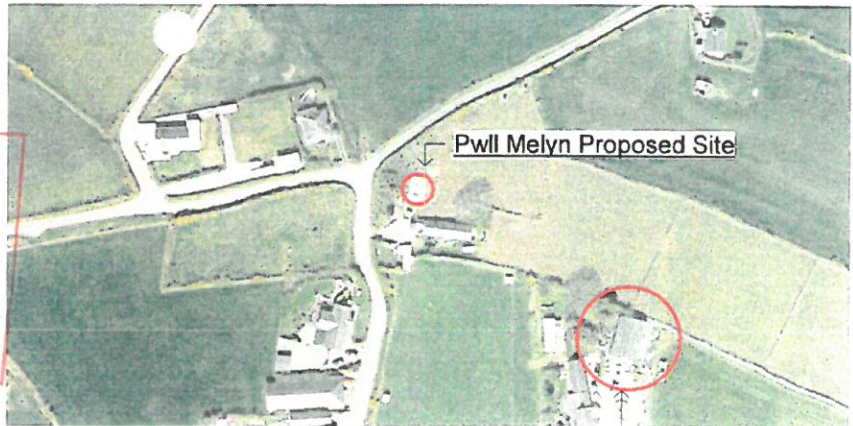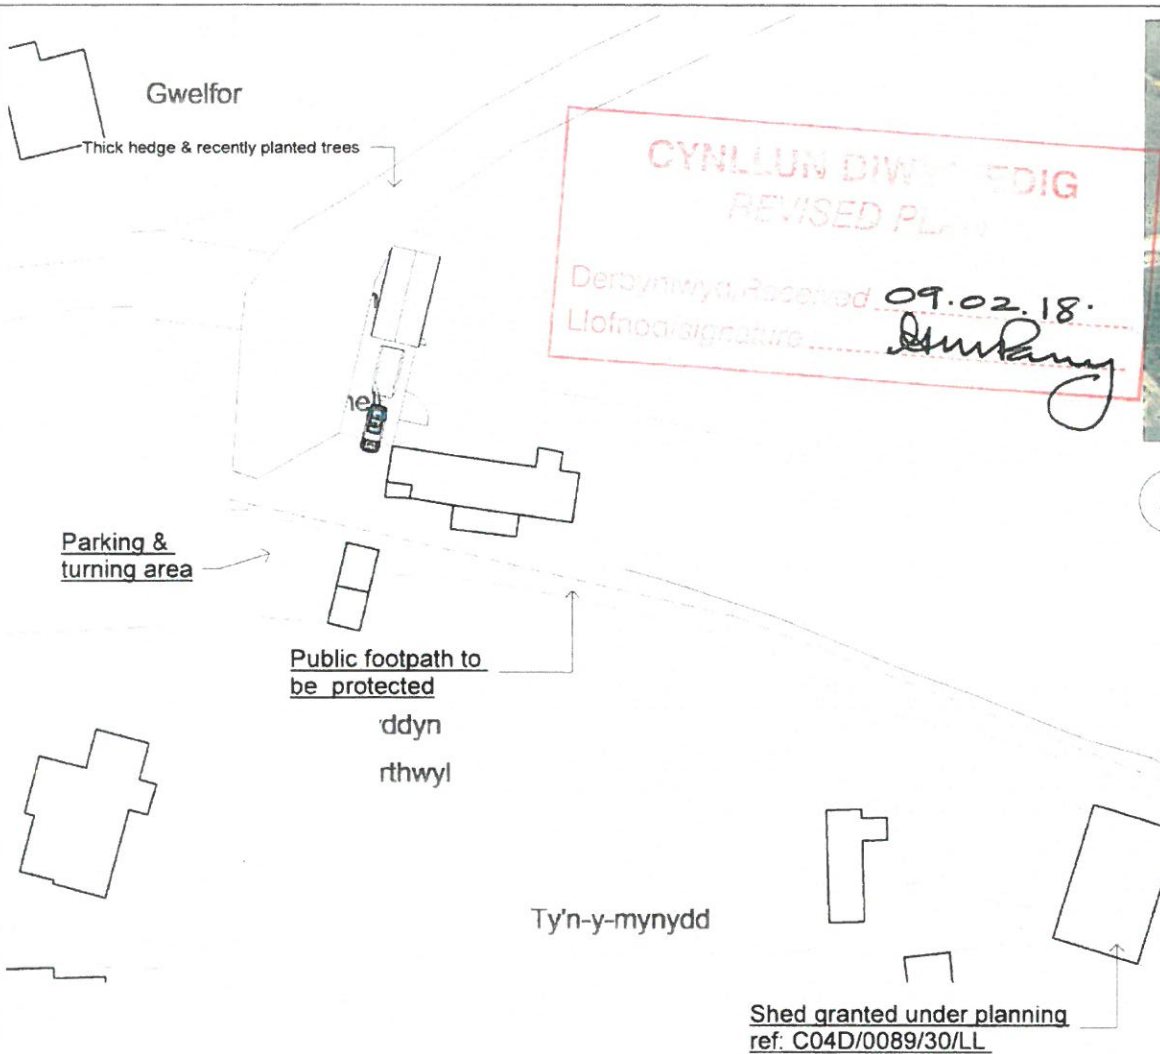

3 Aerial View
1 : 25
Shed granted under planning ref C04D/0089/30/LL

1 Site - Proposed
1 : 500

North

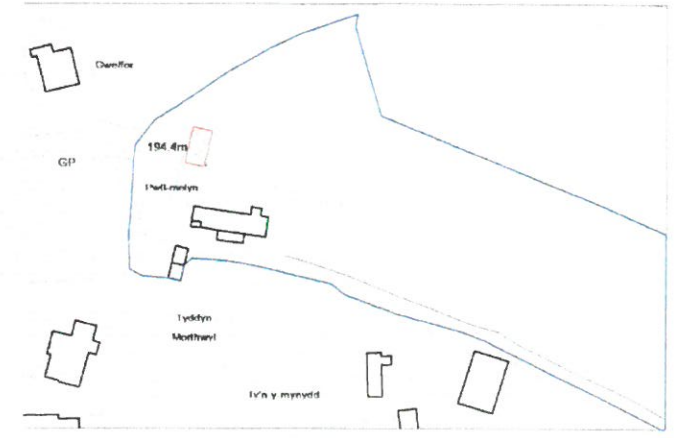

2 Location
1 : 1250

Do not scale this drawing. Contractors must check all dimensions from site. This drawing is copyright


No.	Description	Date
A	Revision 2	04/07/17
B	Relocate & reduce size, roof pitch and height	20/11/2017

Haydn E. Williams Cyf.
Syrfewyr Awdurdod Siartredig
Chartered Building Surveyors

Gellidara, Penrhos, Pwllheli, Gwynedd, LL53 7HF
(01758) 614444
info@haydnwilliams.com
www.haydnwilliams.com

RICS

TEITL PROSIECT - PROJECT TITLE Pwll Melyn, Rhiw		CLEIENT - CLIENT Elizabeth Thornton	
TEITL - TITLE Sifft Location Plan		DYDDIAD - DATE 02/02/17	RHIF PROSIECT - PROJECT NUMBER 0453
		GRADDFA - SCALE (@ A3) As indicated	
		DARLYNWDY GAN DRAWN BY GEW	RHIF CYNLLUN - DRAWING NUMBER 0453-L101
		GWIRWYD GAN CHECKED BY HEW	REV B

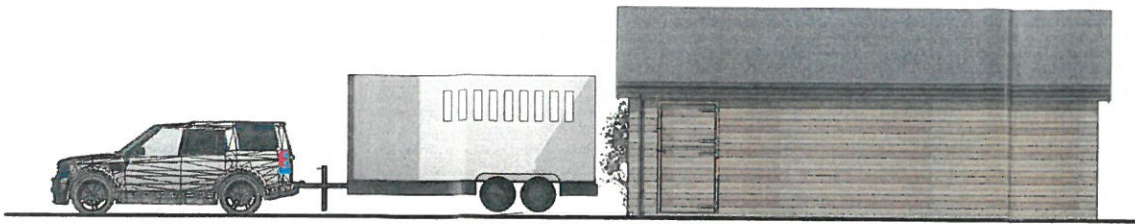




Outline of existing roof slope shown in red.
Proposed reduction in roof height by changing to a duo pitched roof and dropping eaves height. Increase roof pitch as recommended by Gwynedd Council Conservation Officer.

CYNLLUN DIWYGIEDIG
REVISED PLAN
Derbynwyd Received 09.02.18.
Llofnod/signature *[Signature]*

2 East - Proposed
1 : 100


3 South - Proposed
1 : 100

- Dark grey to BS 18B29 profiled roofing sheets.
- Timber cladded blockwork walls.

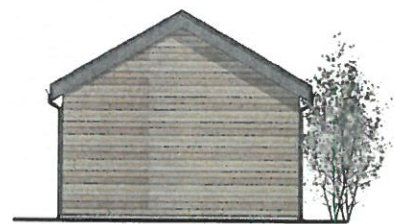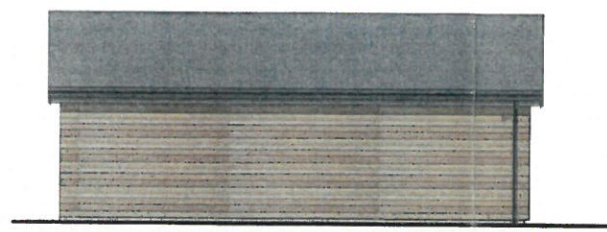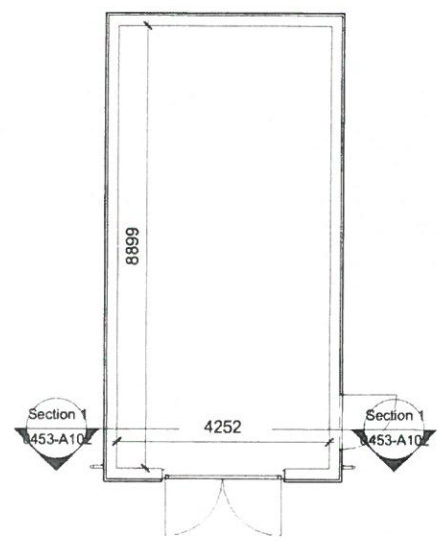


4 West - Proposed
1 : 100

5 North - Proposed
1 : 100

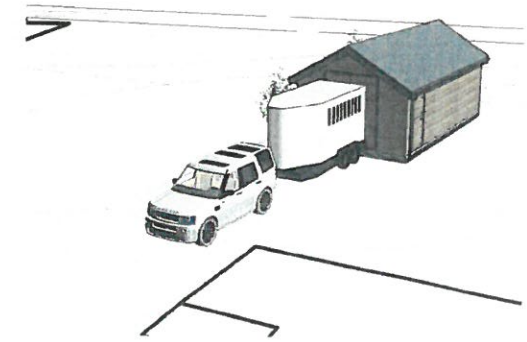

1 Level 0 - Proposed
1 : 100

7 Section 1
1 : 100

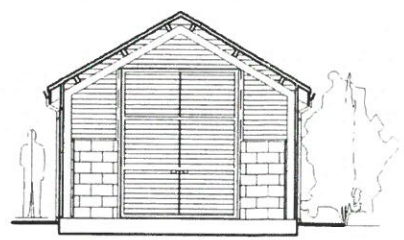

Do not scale this drawing. Contractors must check all dimensions from site. This drawing is copyright

No.	Description	Date
A	Reduce roof height	30/3/17
B	Revision 2	04/07/17
C	Relocate & reduce size, roof pitch and height	20/11/2017
D	Increase pitch, materials	07/02/18

Haydn E. Williams Cyf.
Syrfewyr Adeiladu Siartredig
Chartered Building Surveyors

RICS
Gellidara, Penrhos, Pwllheli, Gwynedd, LL53 7HF
(01758) 614444
info@haydnwilliams.com
www.haydnwilliams.com

TEITL PROSIECT - PROJECT TITLE Pwll Melyn, Rhiw	CLEIENT - CLIENT Elizabeth Thornton	
TEITL - TITLE As Proposed	DYDDIAD - DATE 02/02/17	RHIF PROSIECT - PROJECT NUMBER 0453
	DARLYNHYD GAN DRAWN BY HEW	GRADDFA - SCALE (@ A3) 1 : 100
	GWIRHYD GAN CHECKED BY GEW	RHIF CYNLLUN - DRAWING NUMBER 0453-A102
		REV D