


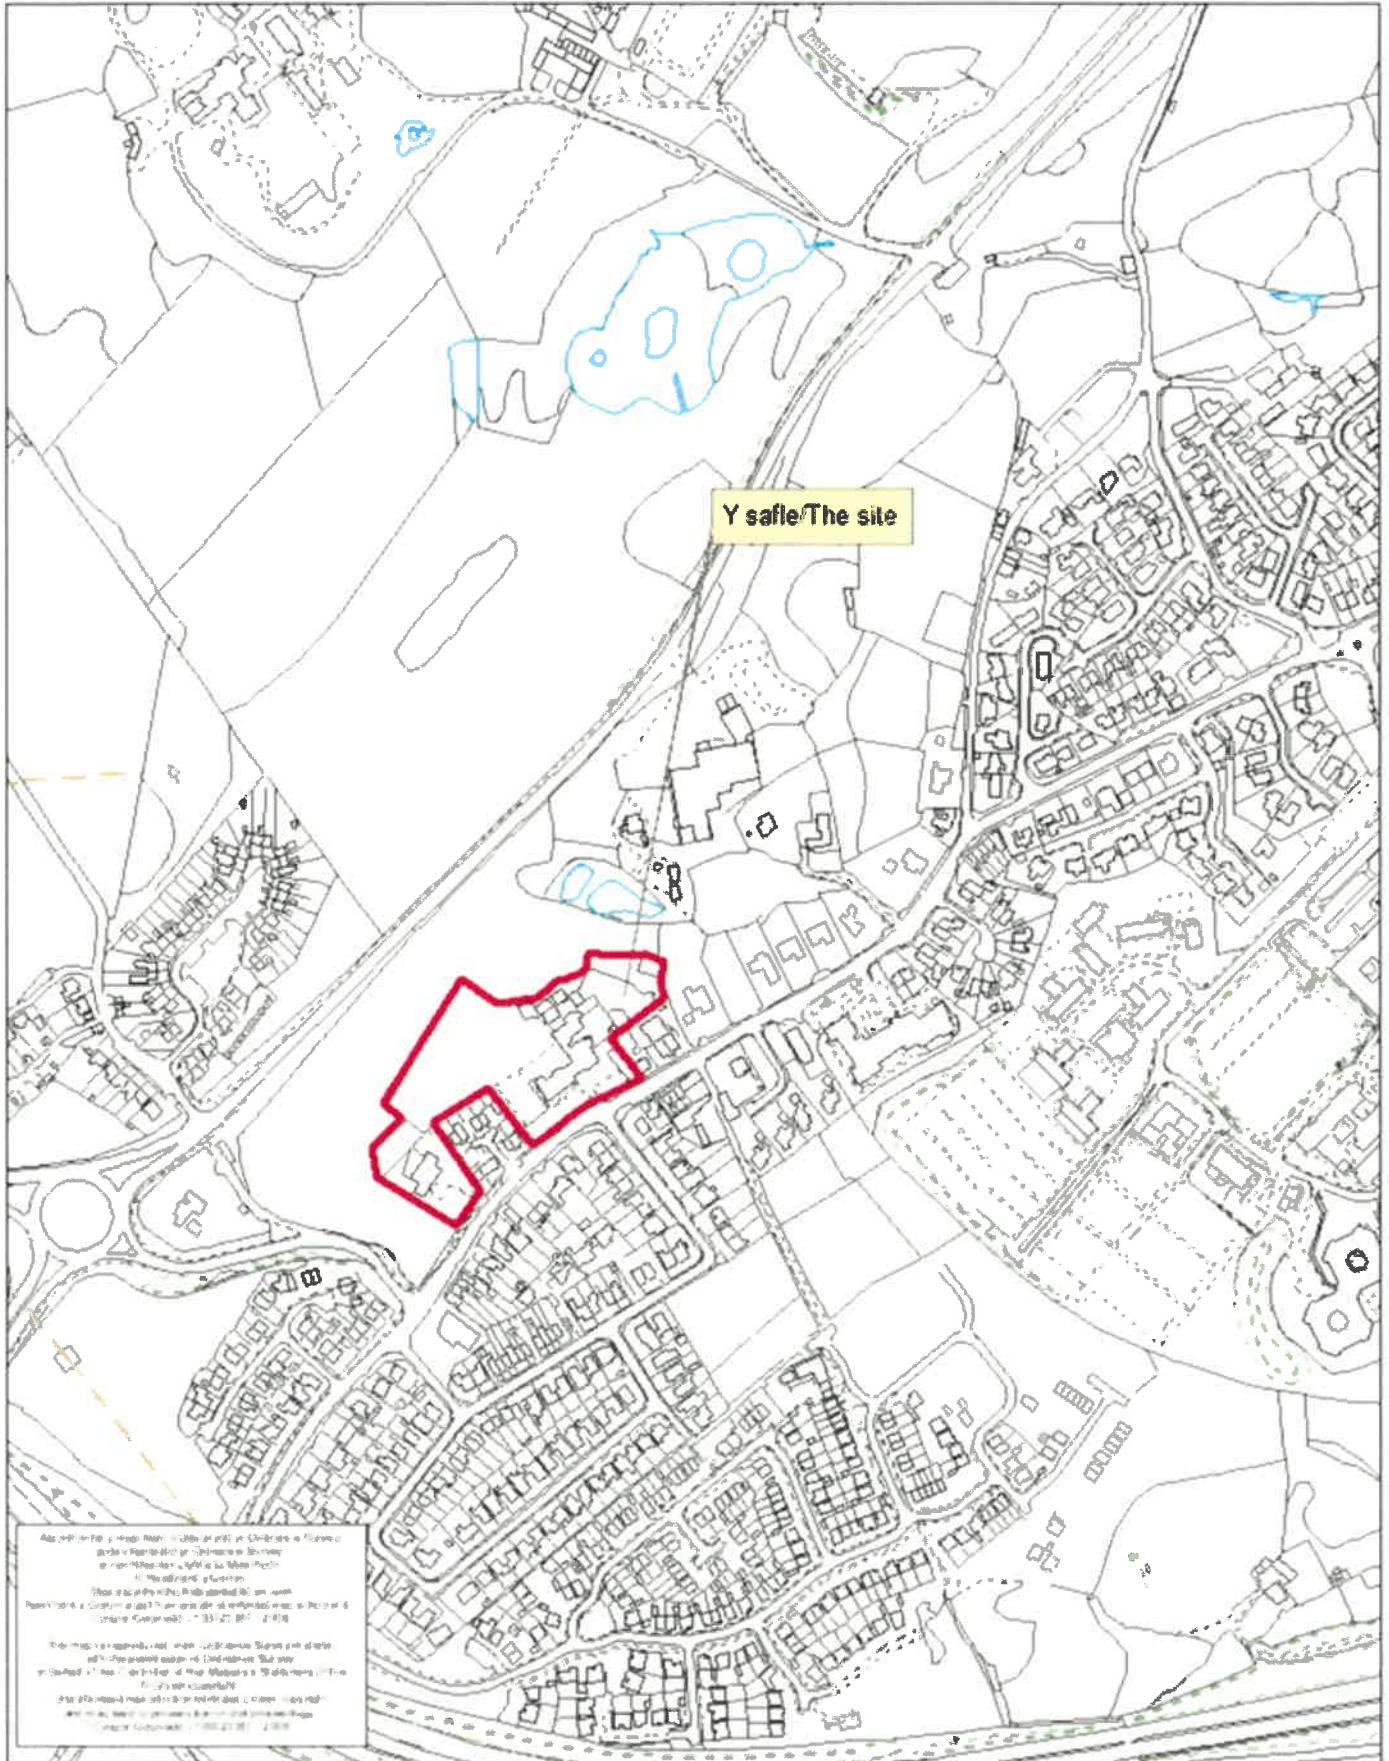

Rhif y Cais / Application Number : C19/0087/25/R3

Cynllun lleoliad ar gyfer adnabod y safle yn unig. Dim i raddfa.
Location Plan for identification purposes only. Not to scale.




Mapiau a Rheoliwr y Cymuned - Lloegr a'r Ddwyrain
 Rhif y Cais / Application Number : C19/0087/25/R3
 Rhif y Cais / Application Number : C19/0087/25/R3

CLIENT/CLIENT:

NODIADAU/NOTES

- DO NOT SCALE FROM DRAWING.
- CHECK ALL DIMENSIONS ON SITE PRIOR TO COMMENCEMENT.
- IF IN DOUBT ASK.

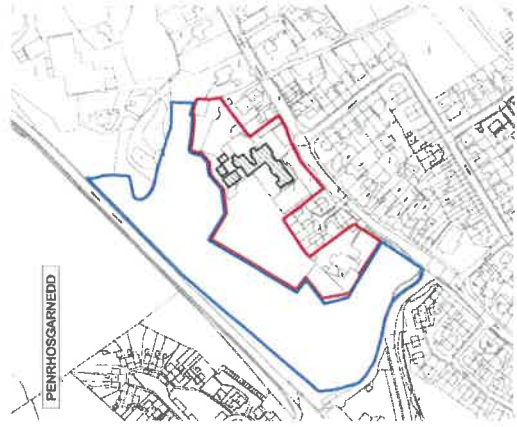

Rev Description Date



01248 479605 | www.ygc.co.uk | ygc@ygc.co.uk
 YGC, Stryd y Ffôn, Stryd y Ffôn, Caerwyn, Gwynedd, LL55 1SH.
 CYLLUN / SCHEME:

AILDDATBLYGIAD YSGOL Y FAENOL
 REDDEVELOPMENT, PENRHOSGARNEDD, BANGOR,
 LL57 2PD

TITL LUNIAID / DRAWING TITLE:

CYLLUN LLEOLIAD A SAFLU PRESENOL -
 LOCATION AND EXISTING BLOCK PLAN

DATE OF DRAWING:	29.01.2019
DATE OF REVISION:	
DATE OF CHECK:	
DATE OF APPROVAL:	
SCALE:	As Indicated @ A1
DRAWING NO.:	001

CYLLUN SAFLU PRESENOL - EXISTING BLOCK PLAN
1:500

CYLLUN LLEOLIAD - LOCATION PLAN
1:500

- Access Road - Permeable Tarmac
- Parking bays - 200x100 block paving with permeable tarmac. Colour to be agreed with planners
- Main Footpaths - 100x100 block paving laid in herringbone pattern. Colour to be agreed with planners
- Soft landscaping - grass or planting to Landscape Architects proposals
- Specialist/functional/highway areas - tarmac

REV	DESCRIPTION	BY	DATE

PLANNING

JP Structural Design

PROJECT

YSGOL Y FAENOL

EXTERNAL LAYOUT AND HIGHWAY ALTERATIONS

CLIENT


CYNGOR GWYNEDD COUNCIL

DRAWN BY: JP DATE: 25.01.2010

SCALE (B4): 1:300 PROJECT NUMBER: 14009

DATE: 14/09/09

REV: A

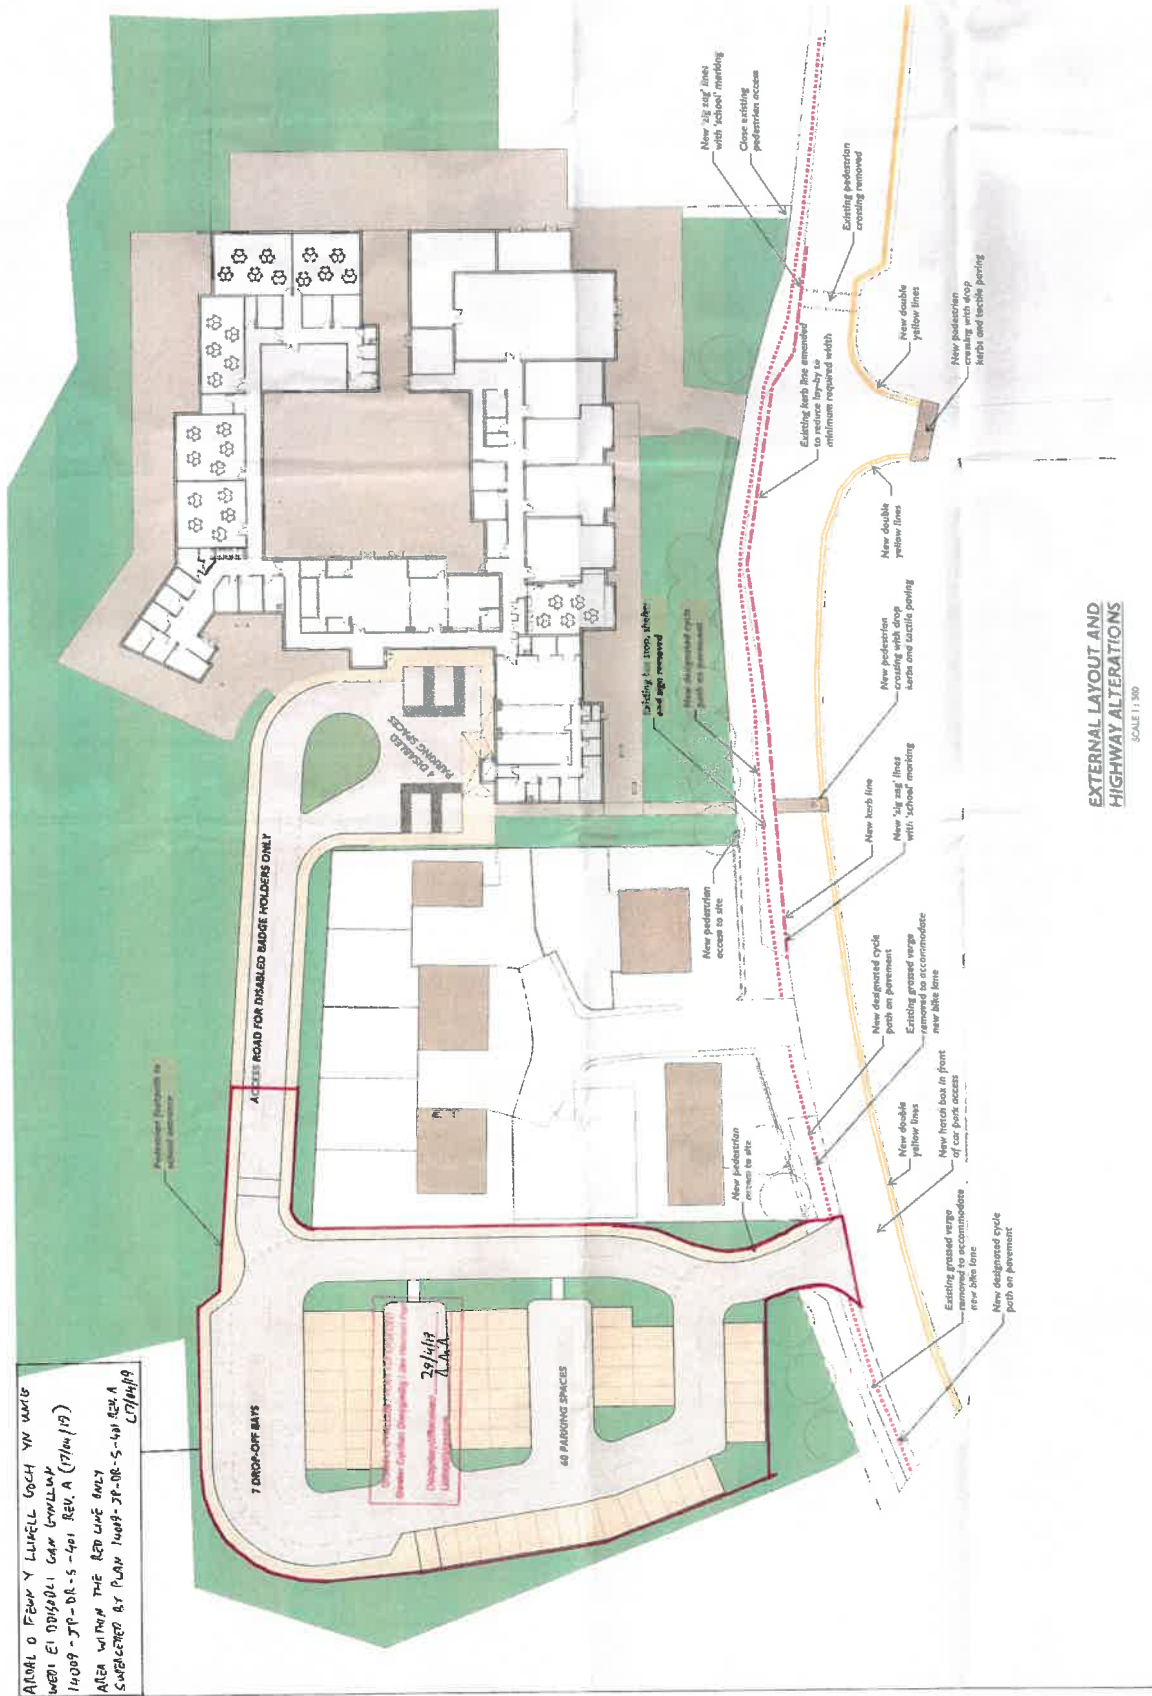

ALOML O FEW Y LUNELL GOCH YN WREIG
 WYBRI EI DDIGSOLI CAN GWYLLWY
 14009-JP-DR-S-401 REV. A (17/04/12)
 AREA WITHIN THE RED LINE ONLY
 CHECKED BY PLAN 14009-JP-DR-S-401 REV. A
 17/04/12


29/11/12
 Checked by: [Signature]
 Drawn by: [Signature]

EXTERNAL LAYOUT AND HIGHWAY ALTERATIONS
 SCALE 1:300

A	EXTERNAL LAYOUTS & VEHICLE TRACKING	B	20.03.2019
REV	DESCRIPTION	BY	DATE
JP Structural Design			
PROJECT YSGOL Y FAENOL			
TITLE EXTERNAL LAYOUT - CAR PARK & ACCESS ROAD			
CLIENT GWYNEDD CONSULTANCY			
DRAWN BY IB	CHECKED BY JP	DATE 17.04.2019	
SCALE (A1) 1:200	PROJECT NUMBER 14009		PROJECT NAME 14009
DRAWING NUMBER 14009-JP-DR-S-401			REV A

GWYNEDD Y CHIRIANGOL
ADDITIONAL INFORMATION
Performed/Reviewed.....*23/4/19*
Layout signature.....*Kat*

EXTERNAL LAYOUT
SCALE 1:200

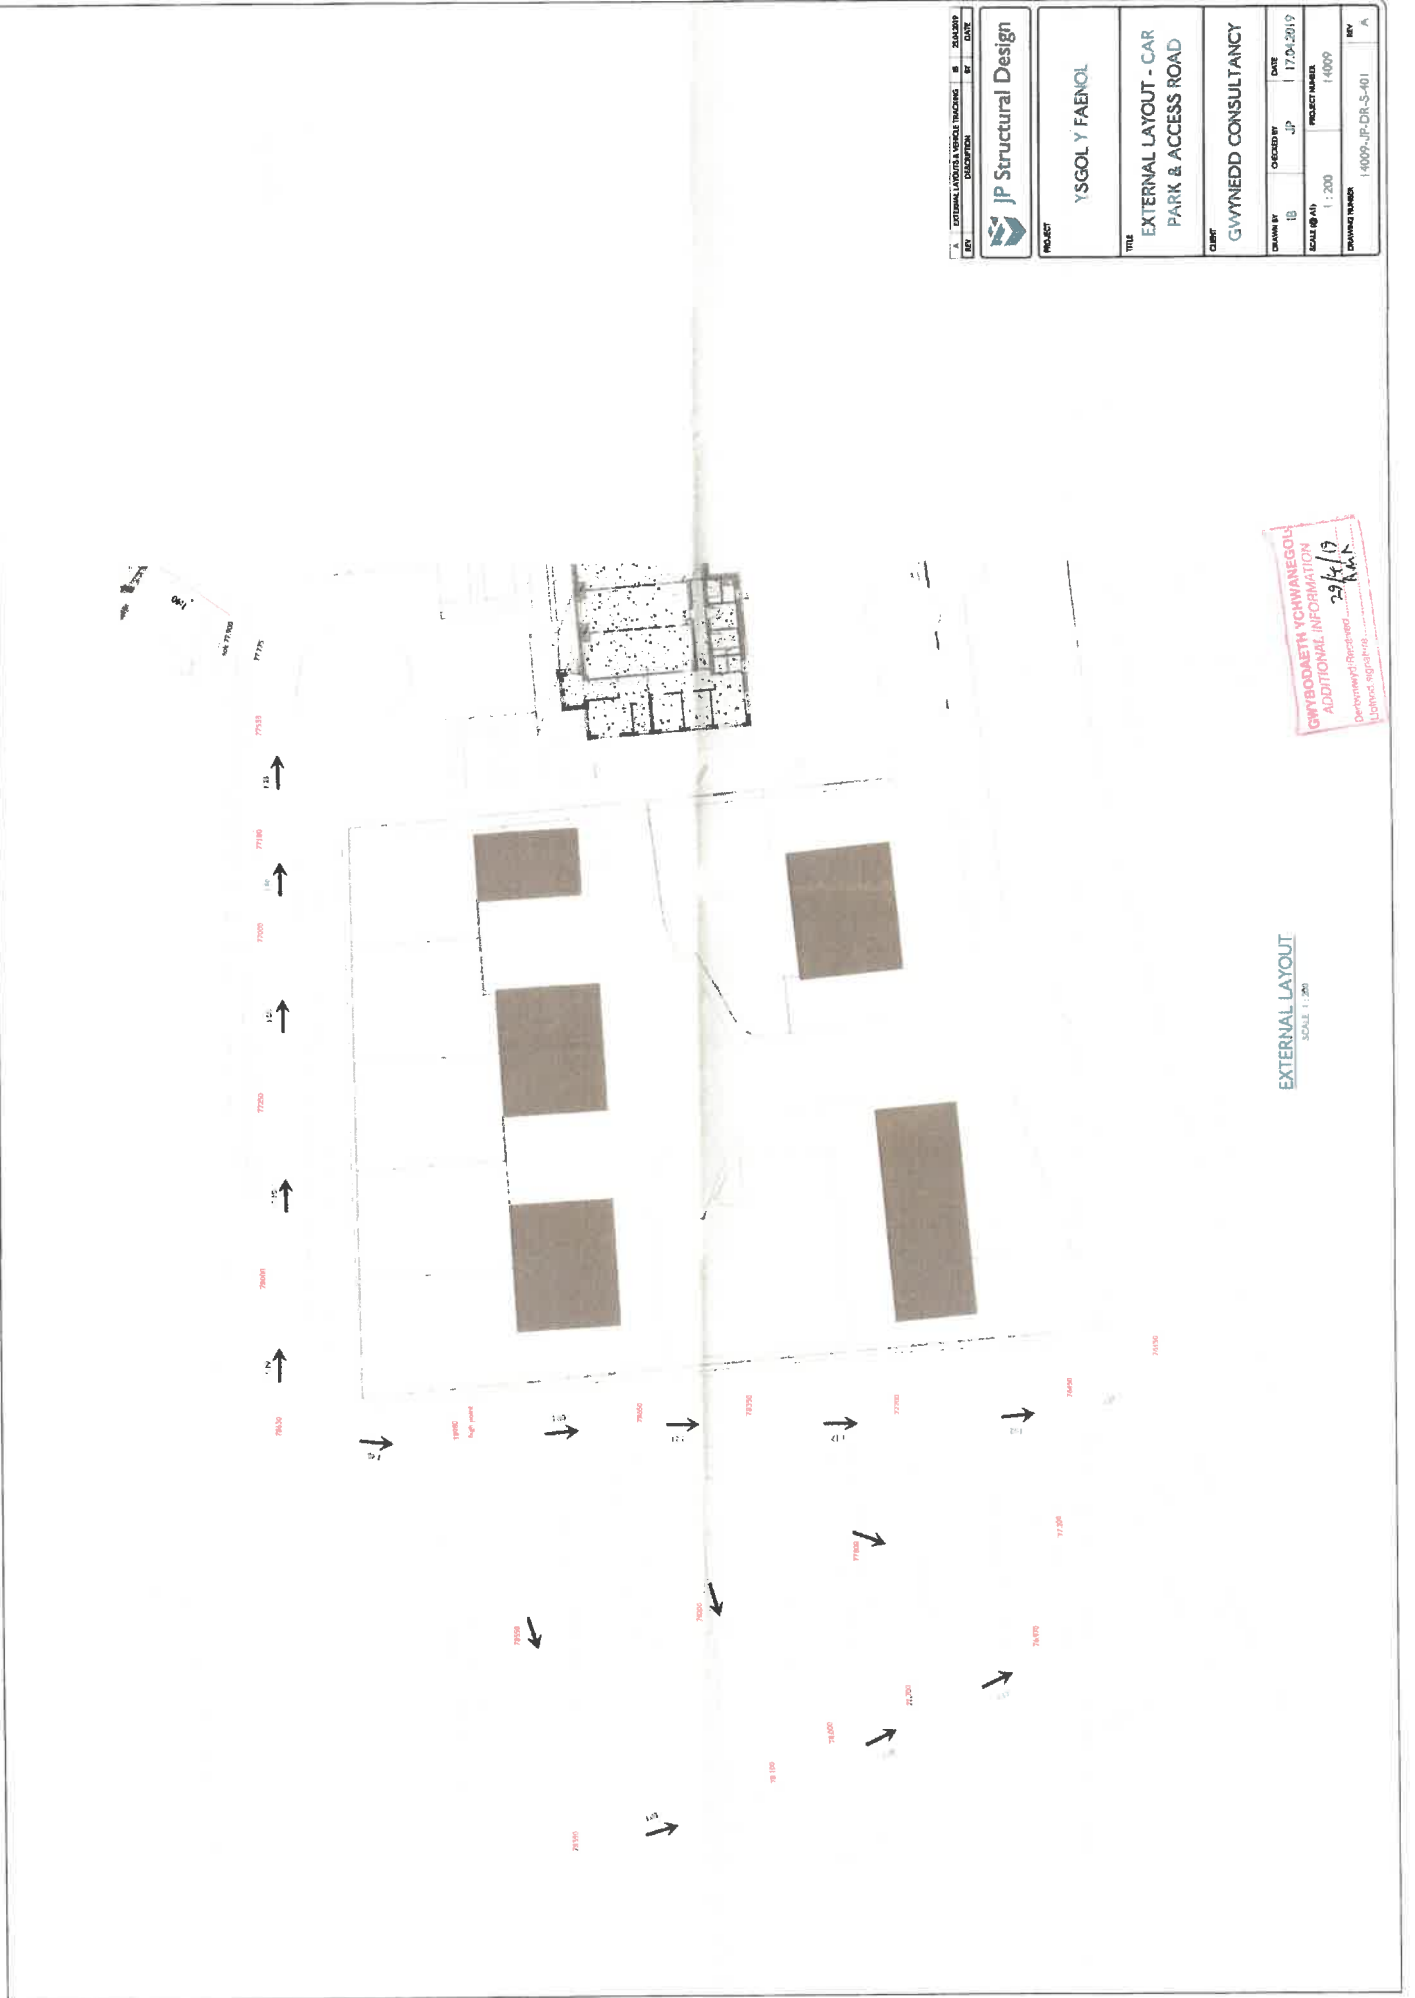

CLIENT/CLIENT:

MODIADAU/NOTES

- DO NOT SCALE FROM DRAWING.
- CHECK ALL DIMENSIONS ON SITE PRIOR TO COMMENCEMENT.
- IF IN DOUBT ASK.

Rev Description Date



01246576636 # www.ygc.cymru # 08007990654 f ygc.cymru

YGC, Stryd y Castell, 7, Cylleir, Gwynedd, LL55 1SH.


CYLLUN / SCHEME:

AILDDATLYGIAD YSEOL Y FAENOL
REDEVELOPMENT, PENRHOSGARNEDD, BANGOR,
LL57 2PD

TITL LUNNOD / DRAWING TITLE:

CYLLUN TO ARFAETHNIG - PROPOSED ROOF
PLAN 1 of 2


DLUNWYDD GŦN:	ATR	DEDIADW DDIUNWYDD:	29/01/19
GWYBODAETHW GŦN:	ATR	DEDIADW GWYBODAETHW:	
GWYBODAETHW GŦN:	ATR	DEDIADW GWYBODAETHW:	
GWYBODAETHW GŦN:	ATR	DEDIADW GWYBODAETHW:	
Ymgyngoriaeth GŦN:		As Iddards@YGC	
Deddfwr GŦN:			
Deddfwr GŦN:			
Deddfwr GŦN:			
Deddfwr GŦN:			

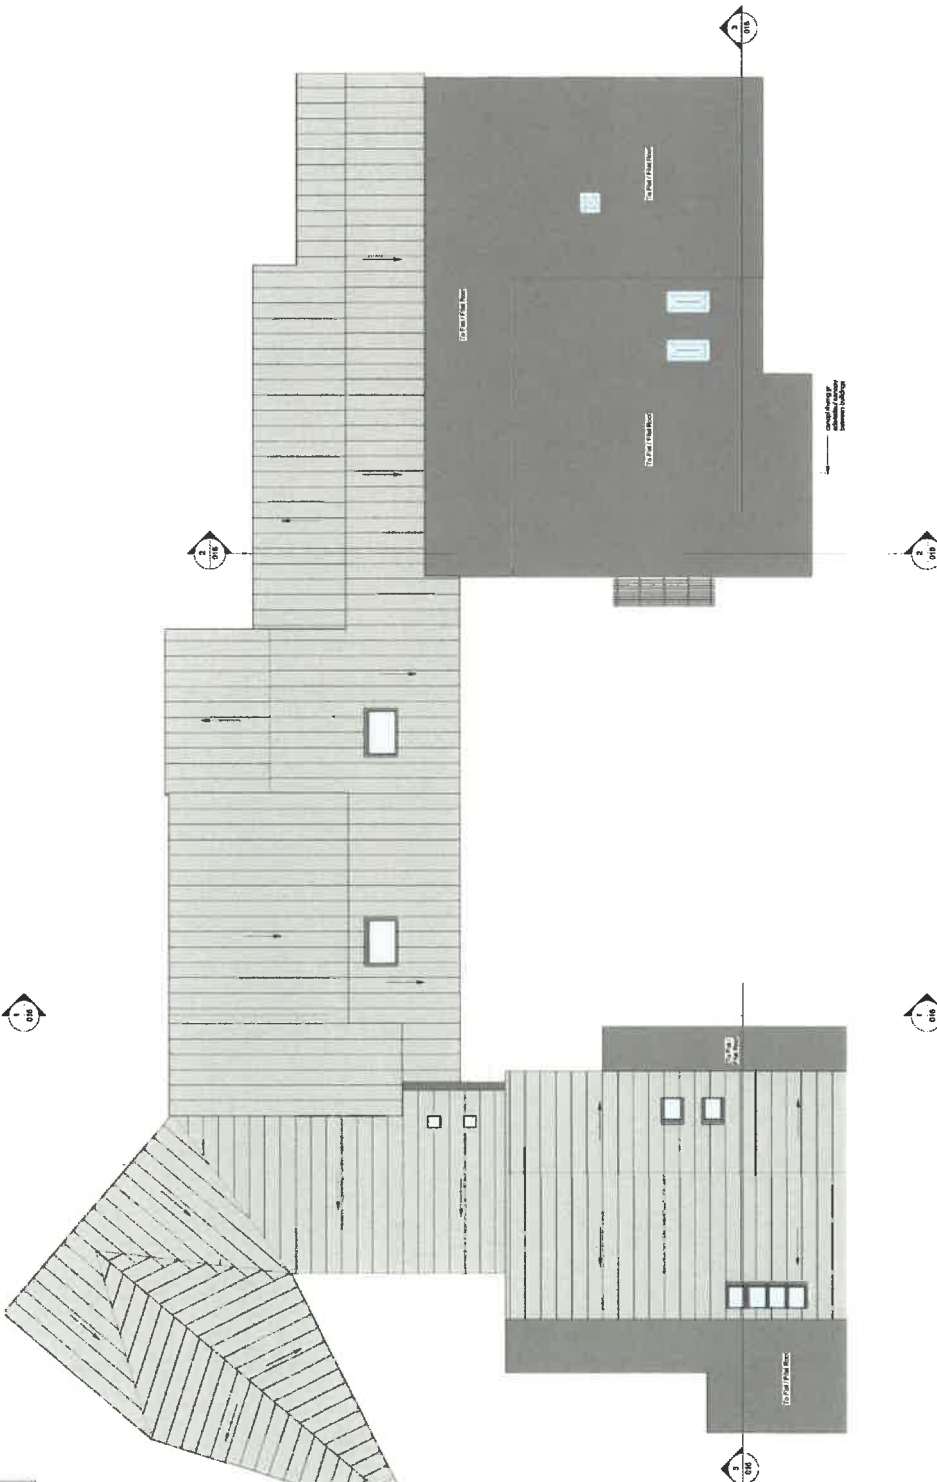

- **MATERIALS**
 - Slate for main roof, gables, dormer, hips
 - Slate for main roof, gables, dormer, hips
 - Slate for main roof, gables, dormer, hips
 - Slate for main roof, gables, dormer, hips
- **ROOFING**
 - 1/2" thick mineral wool roof
 - To West Wall flat roof
 - To East Wall flat roof
 - To North Wall flat roof
 - To South Wall flat roof
- **FINISHES**
 - Slate
 - Slate
 - Slate
 - Slate
- **GENERAL NOTES**
 - All dimensions are in metres unless stated otherwise
 - All dimensions are to the centre of the roof
 - All dimensions are to the centre of the roof
 - All dimensions are to the centre of the roof
- **CONTRACTOR'S NOTES**
 - All dimensions are in metres unless stated otherwise
 - All dimensions are to the centre of the roof
 - All dimensions are to the centre of the roof
 - All dimensions are to the centre of the roof
- **OWNER'S NOTES**
 - All dimensions are in metres unless stated otherwise
 - All dimensions are to the centre of the roof
 - All dimensions are to the centre of the roof
 - All dimensions are to the centre of the roof

CYLLUN TO ARFAETHNIG / PROPOSED ROOF PLAN 1 of 2
1:100

- 1. THIS DRAWING IS THE PROPERTY OF YGC CONSULTANCY. IT IS TO BE USED ONLY FOR THE PROJECT AND SITE SPECIFICALLY IDENTIFIED IN THE TITLE. IT IS NOT TO BE REPRODUCED, COPIED, EITHER WHOLLY OR IN PART, OR TRANSMITTED IN ANY FORM OR BY ANY MEANS, WITHOUT THE WRITTEN PERMISSION OF YGC CONSULTANCY.
- 2. THIS DRAWING IS TO BE USED ONLY FOR THE PROJECT AND SITE SPECIFICALLY IDENTIFIED IN THE TITLE. IT IS NOT TO BE REPRODUCED, COPIED, EITHER WHOLLY OR IN PART, OR TRANSMITTED IN ANY FORM OR BY ANY MEANS, WITHOUT THE WRITTEN PERMISSION OF YGC CONSULTANCY.
- 3. THIS DRAWING IS TO BE USED ONLY FOR THE PROJECT AND SITE SPECIFICALLY IDENTIFIED IN THE TITLE. IT IS NOT TO BE REPRODUCED, COPIED, EITHER WHOLLY OR IN PART, OR TRANSMITTED IN ANY FORM OR BY ANY MEANS, WITHOUT THE WRITTEN PERMISSION OF YGC CONSULTANCY.
- 4. THIS DRAWING IS TO BE USED ONLY FOR THE PROJECT AND SITE SPECIFICALLY IDENTIFIED IN THE TITLE. IT IS NOT TO BE REPRODUCED, COPIED, EITHER WHOLLY OR IN PART, OR TRANSMITTED IN ANY FORM OR BY ANY MEANS, WITHOUT THE WRITTEN PERMISSION OF YGC CONSULTANCY.
- 5. THIS DRAWING IS TO BE USED ONLY FOR THE PROJECT AND SITE SPECIFICALLY IDENTIFIED IN THE TITLE. IT IS NOT TO BE REPRODUCED, COPIED, EITHER WHOLLY OR IN PART, OR TRANSMITTED IN ANY FORM OR BY ANY MEANS, WITHOUT THE WRITTEN PERMISSION OF YGC CONSULTANCY.
- 6. THIS DRAWING IS TO BE USED ONLY FOR THE PROJECT AND SITE SPECIFICALLY IDENTIFIED IN THE TITLE. IT IS NOT TO BE REPRODUCED, COPIED, EITHER WHOLLY OR IN PART, OR TRANSMITTED IN ANY FORM OR BY ANY MEANS, WITHOUT THE WRITTEN PERMISSION OF YGC CONSULTANCY.
- 7. THIS DRAWING IS TO BE USED ONLY FOR THE PROJECT AND SITE SPECIFICALLY IDENTIFIED IN THE TITLE. IT IS NOT TO BE REPRODUCED, COPIED, EITHER WHOLLY OR IN PART, OR TRANSMITTED IN ANY FORM OR BY ANY MEANS, WITHOUT THE WRITTEN PERMISSION OF YGC CONSULTANCY.
- 8. THIS DRAWING IS TO BE USED ONLY FOR THE PROJECT AND SITE SPECIFICALLY IDENTIFIED IN THE TITLE. IT IS NOT TO BE REPRODUCED, COPIED, EITHER WHOLLY OR IN PART, OR TRANSMITTED IN ANY FORM OR BY ANY MEANS, WITHOUT THE WRITTEN PERMISSION OF YGC CONSULTANCY.
- 9. THIS DRAWING IS TO BE USED ONLY FOR THE PROJECT AND SITE SPECIFICALLY IDENTIFIED IN THE TITLE. IT IS NOT TO BE REPRODUCED, COPIED, EITHER WHOLLY OR IN PART, OR TRANSMITTED IN ANY FORM OR BY ANY MEANS, WITHOUT THE WRITTEN PERMISSION OF YGC CONSULTANCY.
- 10. THIS DRAWING IS TO BE USED ONLY FOR THE PROJECT AND SITE SPECIFICALLY IDENTIFIED IN THE TITLE. IT IS NOT TO BE REPRODUCED, COPIED, EITHER WHOLLY OR IN PART, OR TRANSMITTED IN ANY FORM OR BY ANY MEANS, WITHOUT THE WRITTEN PERMISSION OF YGC CONSULTANCY.

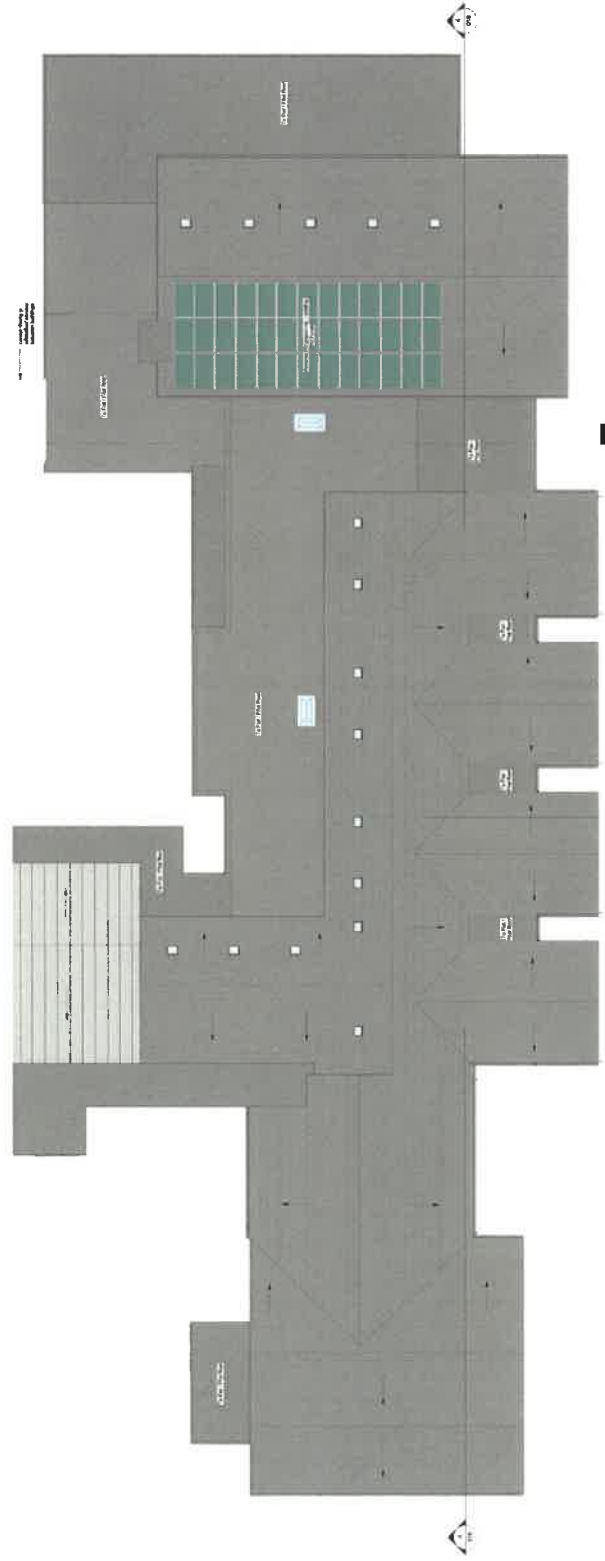

CYLLUN TO ANAETHEDIG PROPOSED ROOF PLAN 2 of 2


CUSTOMER/CLIENT:

NOTES/ADDITIONAL NOTES:


- DO NOT SCALE FROM DRAWING.
- CHECK ALL DIMENSIONS ON SITE PRIOR TO COMMENCEMENT.
- IF IN DOUBT, ASK.

Rev	Description	Date
01	YGC	
02	YGC	
03	YGC	
- 1. DIMENSIONS SHALL BE TO FACE UNLESS OTHERWISE SPECIFIED.
- 2. FINISHES SHALL BE AS SHOWN ON DRAWING UNLESS OTHERWISE SPECIFIED.
- 3. MATERIALS SHALL BE AS SHOWN ON DRAWING UNLESS OTHERWISE SPECIFIED.
- 4. ALL WORK SHALL BE IN ACCORDANCE WITH THE CURRENT EDITIONS OF THE SANS STANDARDS.
- 5. ALL WORK SHALL BE IN ACCORDANCE WITH THE CURRENT EDITIONS OF THE SANS STANDARDS.
- 6. ALL WORK SHALL BE IN ACCORDANCE WITH THE CURRENT EDITIONS OF THE SANS STANDARDS.
- 7. ALL WORK SHALL BE IN ACCORDANCE WITH THE CURRENT EDITIONS OF THE SANS STANDARDS.
- 8. ALL WORK SHALL BE IN ACCORDANCE WITH THE CURRENT EDITIONS OF THE SANS STANDARDS.
- 9. ALL WORK SHALL BE IN ACCORDANCE WITH THE CURRENT EDITIONS OF THE SANS STANDARDS.
- 10. ALL WORK SHALL BE IN ACCORDANCE WITH THE CURRENT EDITIONS OF THE SANS STANDARDS.

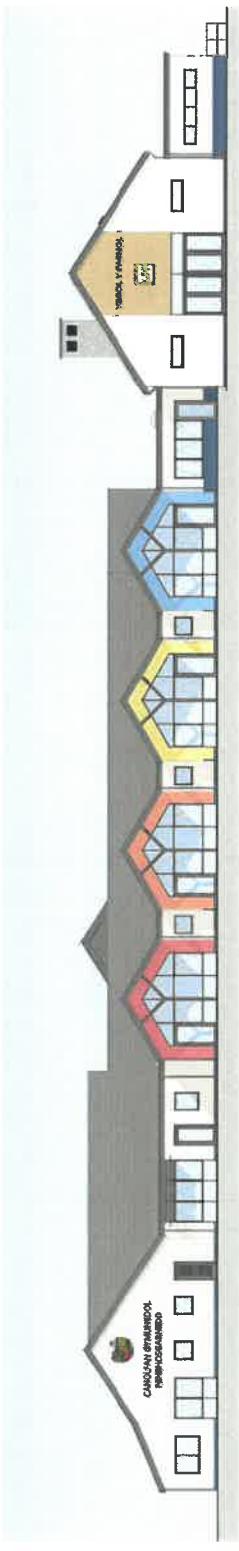

DRYCHAD DE DDWYRAIN ARPETHEDIG - PROPOSED SOUTH EASTERN ELEVATION
1:100

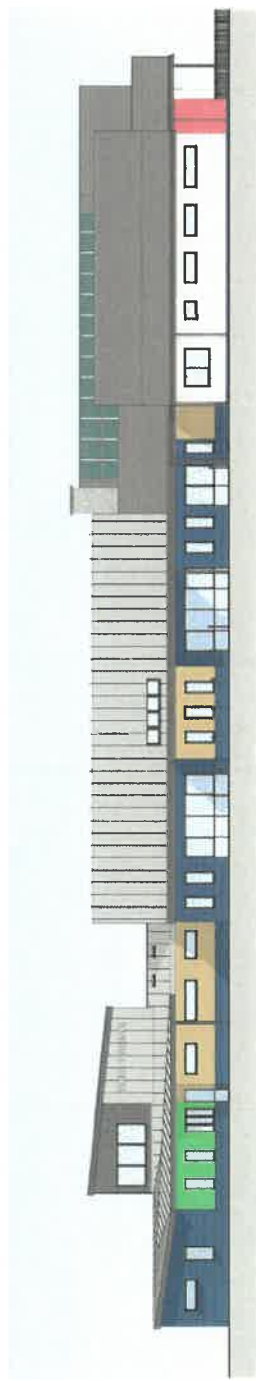

DRYCHAD DE DRELLWYN ARPETHEDIG - PROPOSED SOUTH WEST ELEVATION
1:100



DRYCHAD GOGLEDDO DDWYRAIN ARPETHEDIG - PROPOSED NORTH EASTERN ELEVATION Copy 1
1:100



DRYCHAD GOGLEDDO DRELLWYN ARPETHEDIG - PROPOSED NORTH WESTERN ELEVATION Copy 1
1:100

CURRENT CLIENT:

NOTES:

- DO NOT SCALE FROM DRAWING.
- CHECK ALL DIMENSIONS ON SITE PRIOR TO COMMENCEMENT.
- IF IN DOUBT ASK.

Ref.	Description	Date
------	-------------	------

Yng Ngharfaeth
Gwynedd
Consultancy

YSG, Pen-y-fryn, Gwynedd, LL57 2PD
YSG, Pen-y-fryn, Gwynedd, LL57 2PD
YSG, Pen-y-fryn, Gwynedd, LL57 2PD


CYLLID / SCHEME:
ALDWATERHEAD SCHOOL FACILITY
REDEVELOPMENT, PERRHOSGARNEDD, BANOR,
LL57 2PD

TITL LUNAD / DRAWING TITLE:
DRYCHAD ARPETHEDIG - PROPOSED
ELEVATIONS 1 OF 2
DATE: 29/01/19
DRAWN BY: ATR
CHECKED BY: ATR
SCALE: As Indicated
DRAWING NO: 014

CUSTOMER/CLIENT :

NOTIADAU/NOTES

- DO NOT SCALE FROM DRAWING.
- CHECK ALL DIMENSIONS ON SITE PRIOR TO COMMENCEMENT.
- IF IN DOUBT ASK.

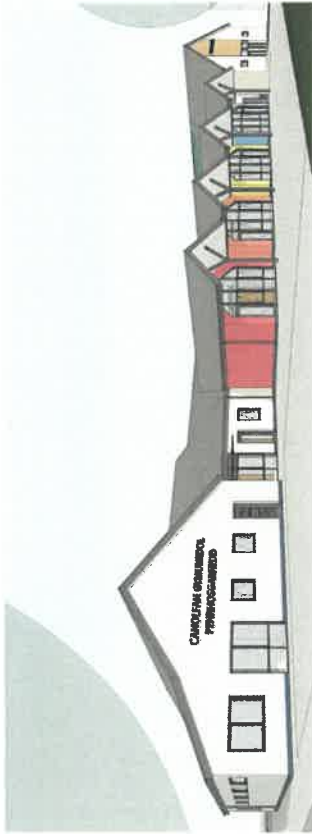

Rev Description Date



01236 679416 | www.ygc.cymru | info@ygc.cymru

YGC, Stryd y Cymoer, Stryd y M. Cernarfon, Gwynedd, LL55 1BH, CYMALLUN / SCHEME

ALDDATBYNGIAD YSGOL Y FAENCL
REDDEVELOPMENT, PENNHOSSGARNEDD, BANGOR,
LL57 2PD

TITL LUNNAG / DRAWING TITLE:

EDRICHAD ALLANCI ARFAETHEDIG- PROPOSED
EXTERNAL VIEWS

ISSUED FOR:	ATR	ISSUE DATE:	29.01.19
DESIGNED BY:	ATR	DATE CHECKED:	
CHECKED BY:		DATE APPROVED:	
Scale:		Scale:	
Sheet:		Sheet:	
Client:	Rhif Limited	Client:	
Drawing No.:		Drawing No.:	017